
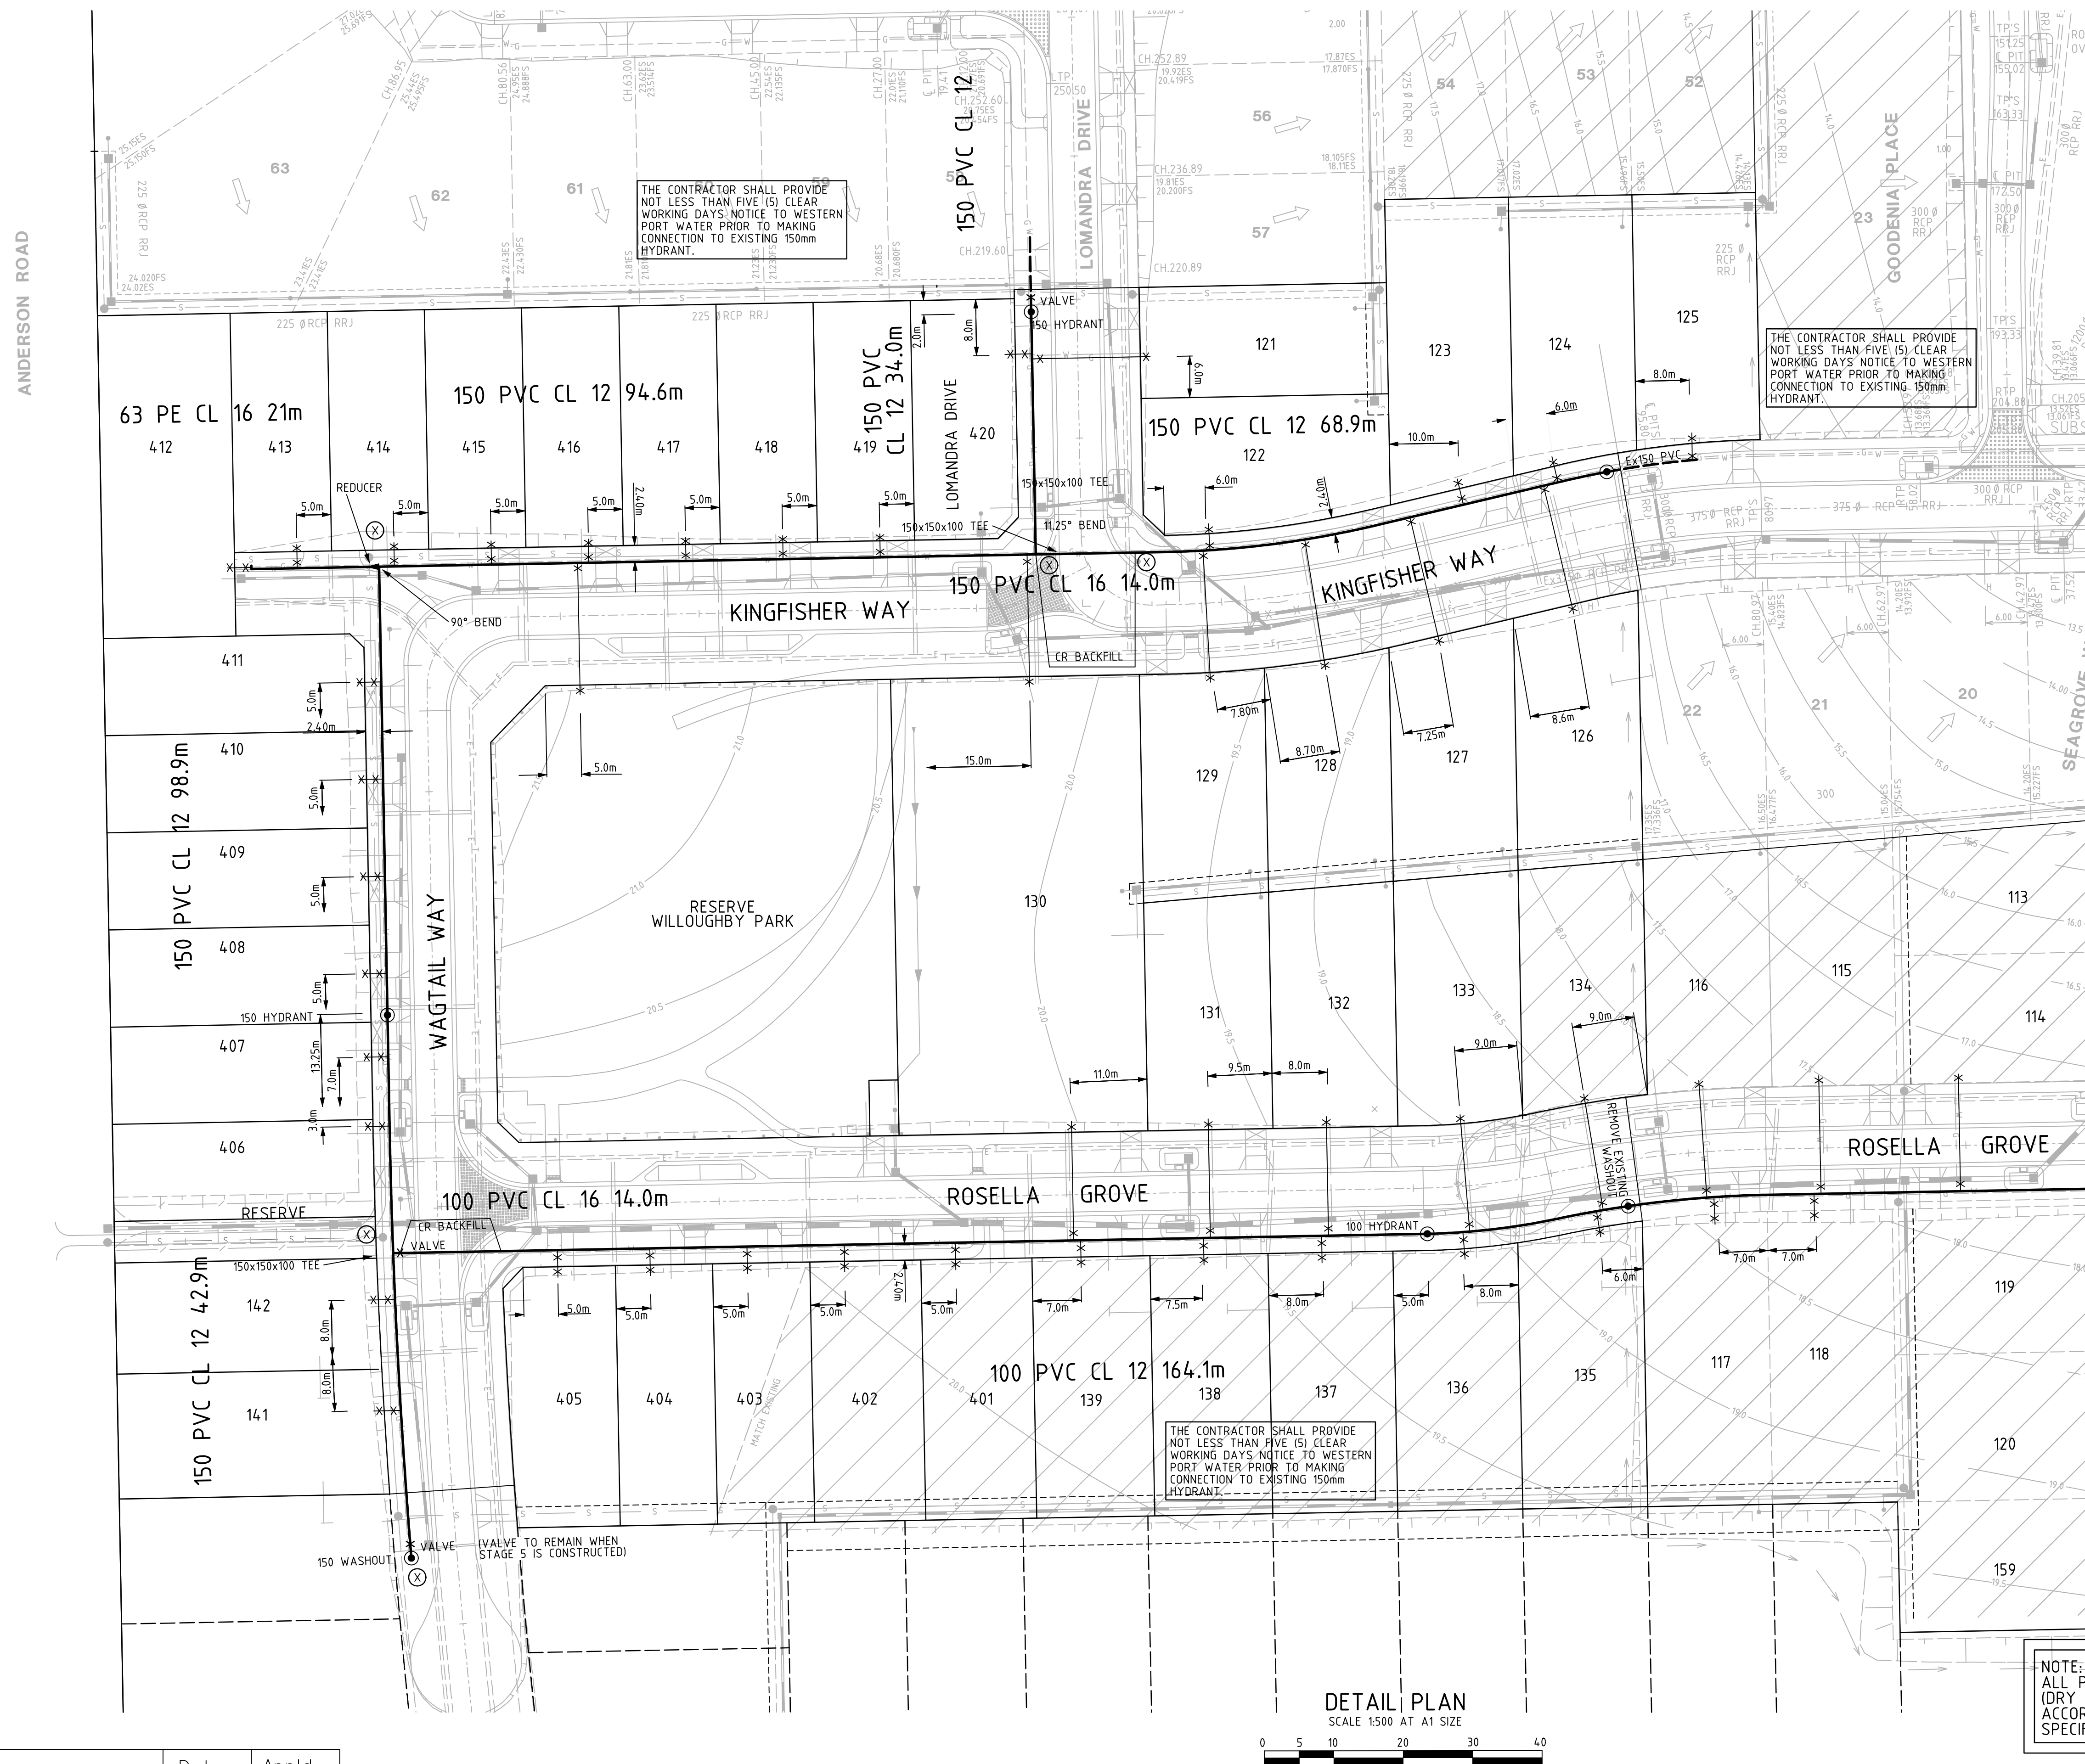
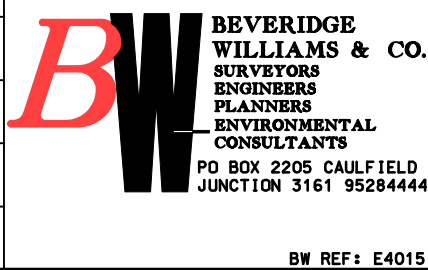


K	27/01/12	AS CONSTRUCTED AMENDMENTS	CW	 <div>Beveridge Williams development & environment consultants Melbourne – 1 Glenferrie Road, Malvern 3144 Ph (03) 9528 4444 Ballarat – 96 Main Road, Ballarat 3350 Ph (03) 5327 2000 Traralgon – Shop 4, 85 Hotham Street, Traralgon 3844 Ph (03) 5176 0374 Leongatha – 52A Bar Street, Leongatha 3953 Ph (03) 5662 2630 Wonthaggi – 134 Graham Street, Wonthaggi 3995 Ph (03) 5672 1505</div>	SURVEY	BEV. WILL. PL	PS 603110H	MUNICIPALITY:	BASS COAST SHIRE COUNCIL		BW REF:4015/4	Scale: As shown @ A1 size	
J	31/10/08	AS CONSTRUCTED	BM		DESIGN	R.KUURMAN	Highways Reference:	631 J2	SCHEME:	SEAGROVE ESTATE - COWES, PHILLIP ISLAND - STAGE 4		Drawing No.	REV
H	19/08/08	AMENDED AS PER BSCS REQUIREMENTS	PS		DRAWN	R.KUURMAN	© COPYRIGHT BEVERIDGE WILLIAMS & CO P/L HAS GRANTED A LICENSE TO THE PRINCIPAL TO USE THIS DOCUMENT FOR ITS INTENDED PURPOSE. NO UNAUTHORISED COPYING IS PERMITTED.		DETAIL PLAN		1880/ 4	K	
G	5/08/08	FOOTPATHS RELOCATED	PS		CHECKED	D.POWELL			PRINCIPAL:	SOUTHERN SUSTAINABLE DEVELOPMENTS		Sheet	4 of 20
F	22/08/08	ISSUED FOR CONSTRUCTION	PS										
INDEX	DATE	REVISION	APPD.										



Revision	Details	Date	App'd
F	ALLOTMENT BOUNDARIES AMENDED	13/5/08	PS
E	TAPPING LOCATION AMENDED	17/3/08	PS
D	ROAD NAMES AMENDED	9/1/08	PS
C	LOTS 140, 143, 144 & 145 RESUBDIVIDED	23/11/07	PS
B	DRAWING No. AND NOTE ADDED	10/7/07	PS



WESTERNPORT WATER
Trading name for:
WESTERPORT REGION WATER CORPORATION
2 Boys Home Road Newhaven 3925
Phone (03) 5952 2393 Fax (03) 5952 3115



Drawn	L.SUTHERLAND
Designed	P.SMITH
Checked	D.POWELL
Date	March 2008
Scale	As Shown

WESTERNPORT WATER
SEAGROVE ESTATE STAGE 4, COWS
WATERMAIN DETAIL PLAN

DRG. NO.
W373
2
sheet 2 of 2

A1



BW BEVERIDGE
WILLIAMS & CO.
SURVEYORS
ENGINEERS
PLANNERS
ENVIRONMENTAL
CONSULTANTS
PO BOX 2205 CAULFIELD
JUNCTION 3161 95284444

WESTERNPORT WATER
SEAGROVE ESTATE STAGE 4, COWES SEWER DETAIL PLAN

DRG. NO.
S563
 2
 sheet 2 of 4

A1

